

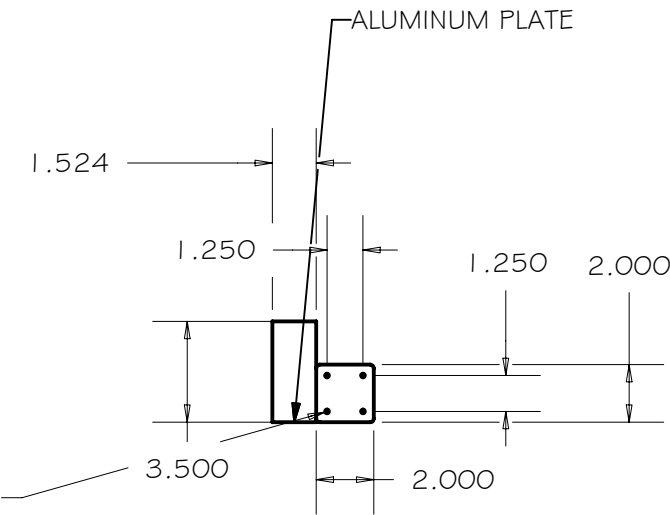


REV	DRWN	CHK'D	DATE	DESCRIPTION
B	VRW	VRW	5/10/05	UPDATE TO AS BUILT, CHANGE ROLLER MOUNTS

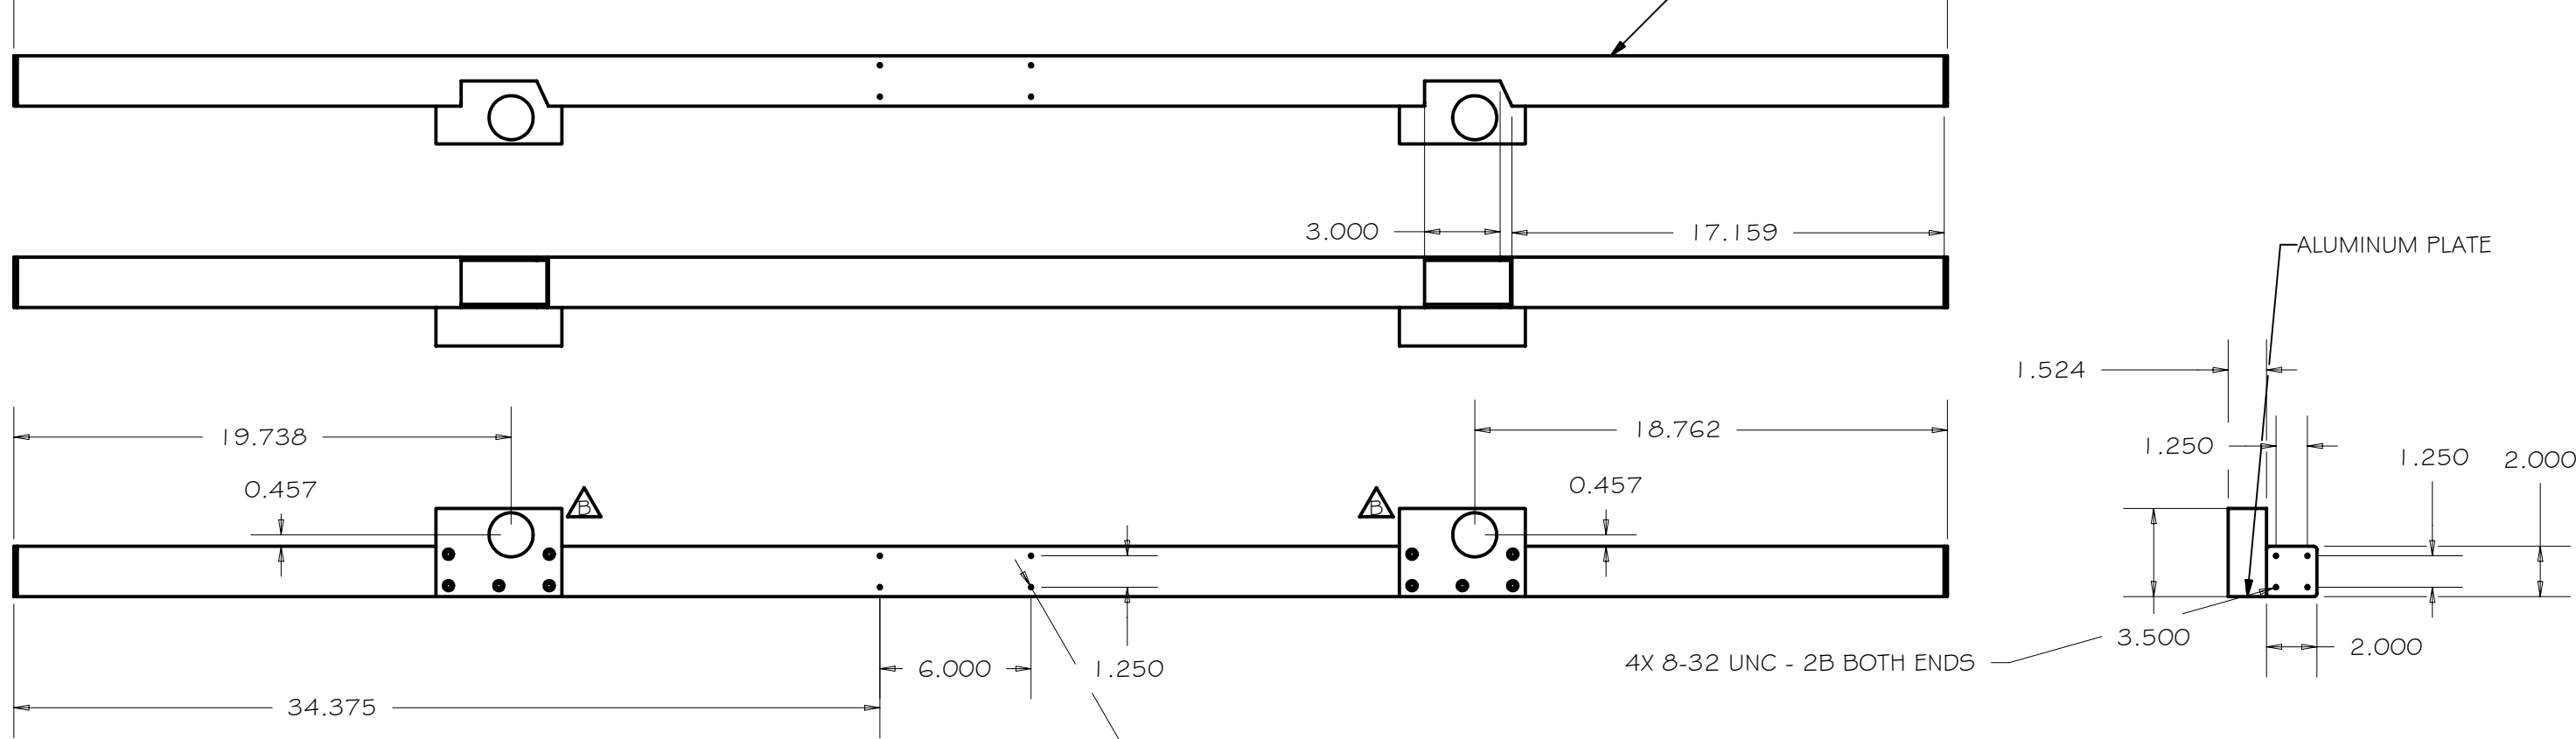

Parts List			
ITEM	QTY	PART NUMBER	DESCRIPTION
1	1	A111	SUPPORT TUBE, LEFT
3	2	A115	ROLLER MOUNT, V
4	2	A123	TUBE END CAP

TOLERANCES UNLESS OTHERWISE NOTED:
 FRACTIONAL: 0"-6": ±1/64" 6"-24": ±1/32"
 24"+: ±1/16"
 DECIMAL: X.X: ±0.1000" X.XX: ±0.0100"
 X.XXX: ±0.0050" X.XXXX: ±0.0001"
 ANGLES: ±0.5° FINISH: 125 MICRO INCHES
 BREAK ALL SHARP EDGES & CORNERS 1/64" MAX

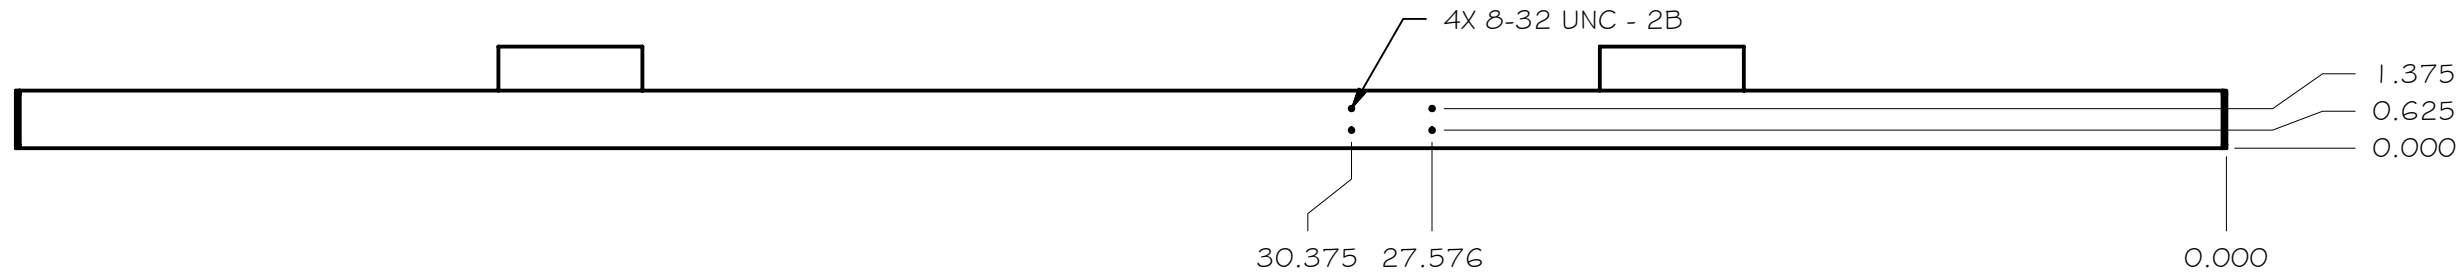

DRAWN: vernon 3/31/2004
 CHECKED: [blank]
 DESIGNED: vernon
 ENGINEER: vernon
 QTY: 1

Cassegrain ADC
 TITLE: SUPPORT WELDMENT, LEFT
 PROJECT CODE: A100
 DWG NO: A110
 REV: B