


REV	DRWN	CHK'D	DATE	DESCRIPTION
B	VRW	VRW	5/9/05	UPDATE TO AS BUILT & ADD ANGLED CUTS

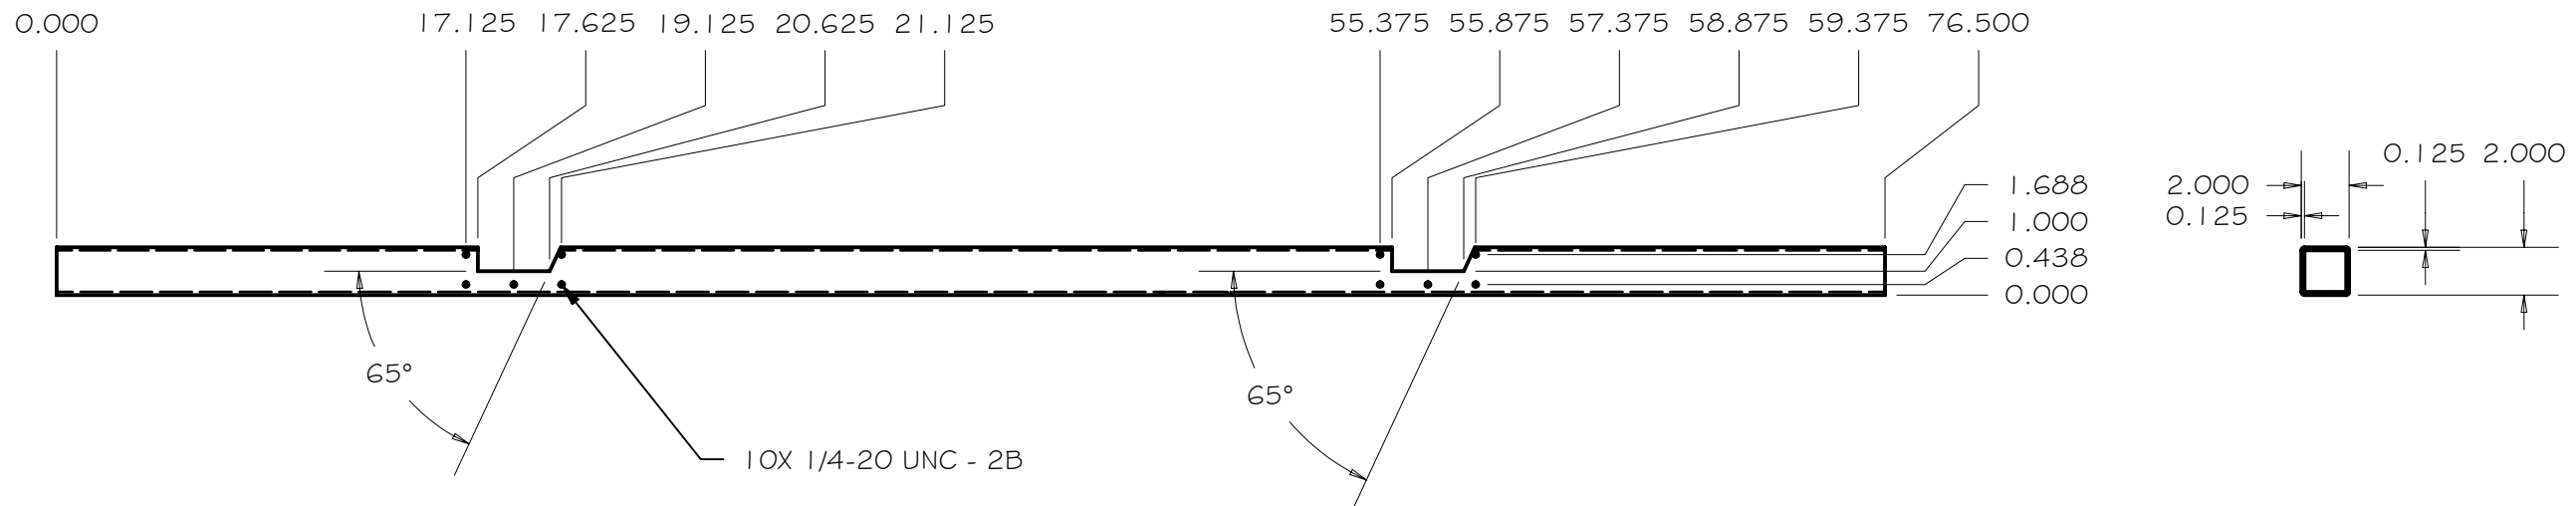


SCALE 1 / 8

TOLERANCES UNLESS OTHERWISE NOTED:  
 FRACTIONAL: 0"-6": ±1/64" 6"-24": ±1/32"  
 24"+: ±1/16"  
 DECIMAL: X.X: ±0.1000" X.XX: ±0.0100"  
 X.XXX: ±0.0050" X.XXXX: ±0.0001"  
 ANGLES: ±0.5° FINISH: 125 MICRO INCHES  
 BREAK ALL SHARP EDGES & CORNERS 1/64" MAX

MATERIAL  
ALUMINUM

FINISH

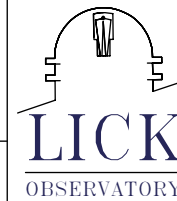

DRAWN: vernon  
 CHECKED:  
 DESIGNED: vernon  
 ENGINEER: vernon

QTY: 1

5/9/2005  
 Cassegrain ADC

TITLE  
SUPPORT TUBE, LEFT

PROJECT CODE  
NEXT ASSY  
A110

DWG NO  
A111

REV  
A  
1