


REV	DRWN	CHK'D	DATE	DESCRIPTION
B	VRW	VRW	5/11/05	UPDATE TO AS BUILT & ADD ANGLED CUTS

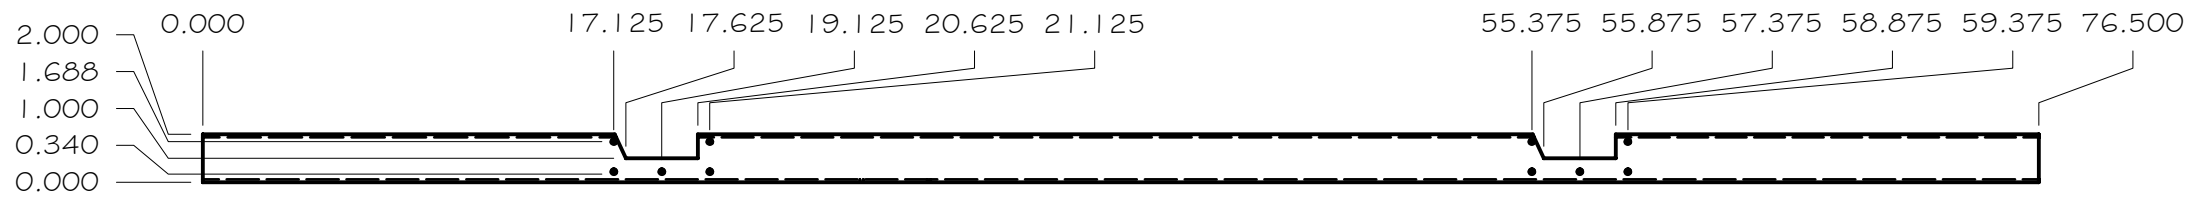

SCALE 1 / 8

TOLERANCES UNLESS OTHERWISE NOTED: FRACTIONAL: 0"-6": ±1/64" 6"-24": ±1/32" 24"+: ±1/16" DECIMAL: X.X: ±0.1000" X.XX: ±0.0100" X.XXX: ±0.0050" X.XXXX: ±0.0001" ANGLES: ±0.5° FINISH: 125 MICRO INCHES BREAK ALL SHARP EDGES & CORNERS 1/64" MAX			DRAWN: vernon CHECKED: DESIGNED: vernon ENGINEER: vernon	DATE: 5/11/2005	PROJECT CODE: A100 DWG NO: A131	REV: B 1/1
MATERIAL: ALUMINUM FINISH:	QTY: 1		TITLE: Cassegrain ADC SUPPORT TUBE, RIGHT	NEXT ASSY:		