


REV	DRWN	CHK'D	DATE	DESCRIPTION
B	VRW	VRW	1/3/05	ADD TOOLING BALL
C	VRW	VRW	2/7/05	AS BUILT

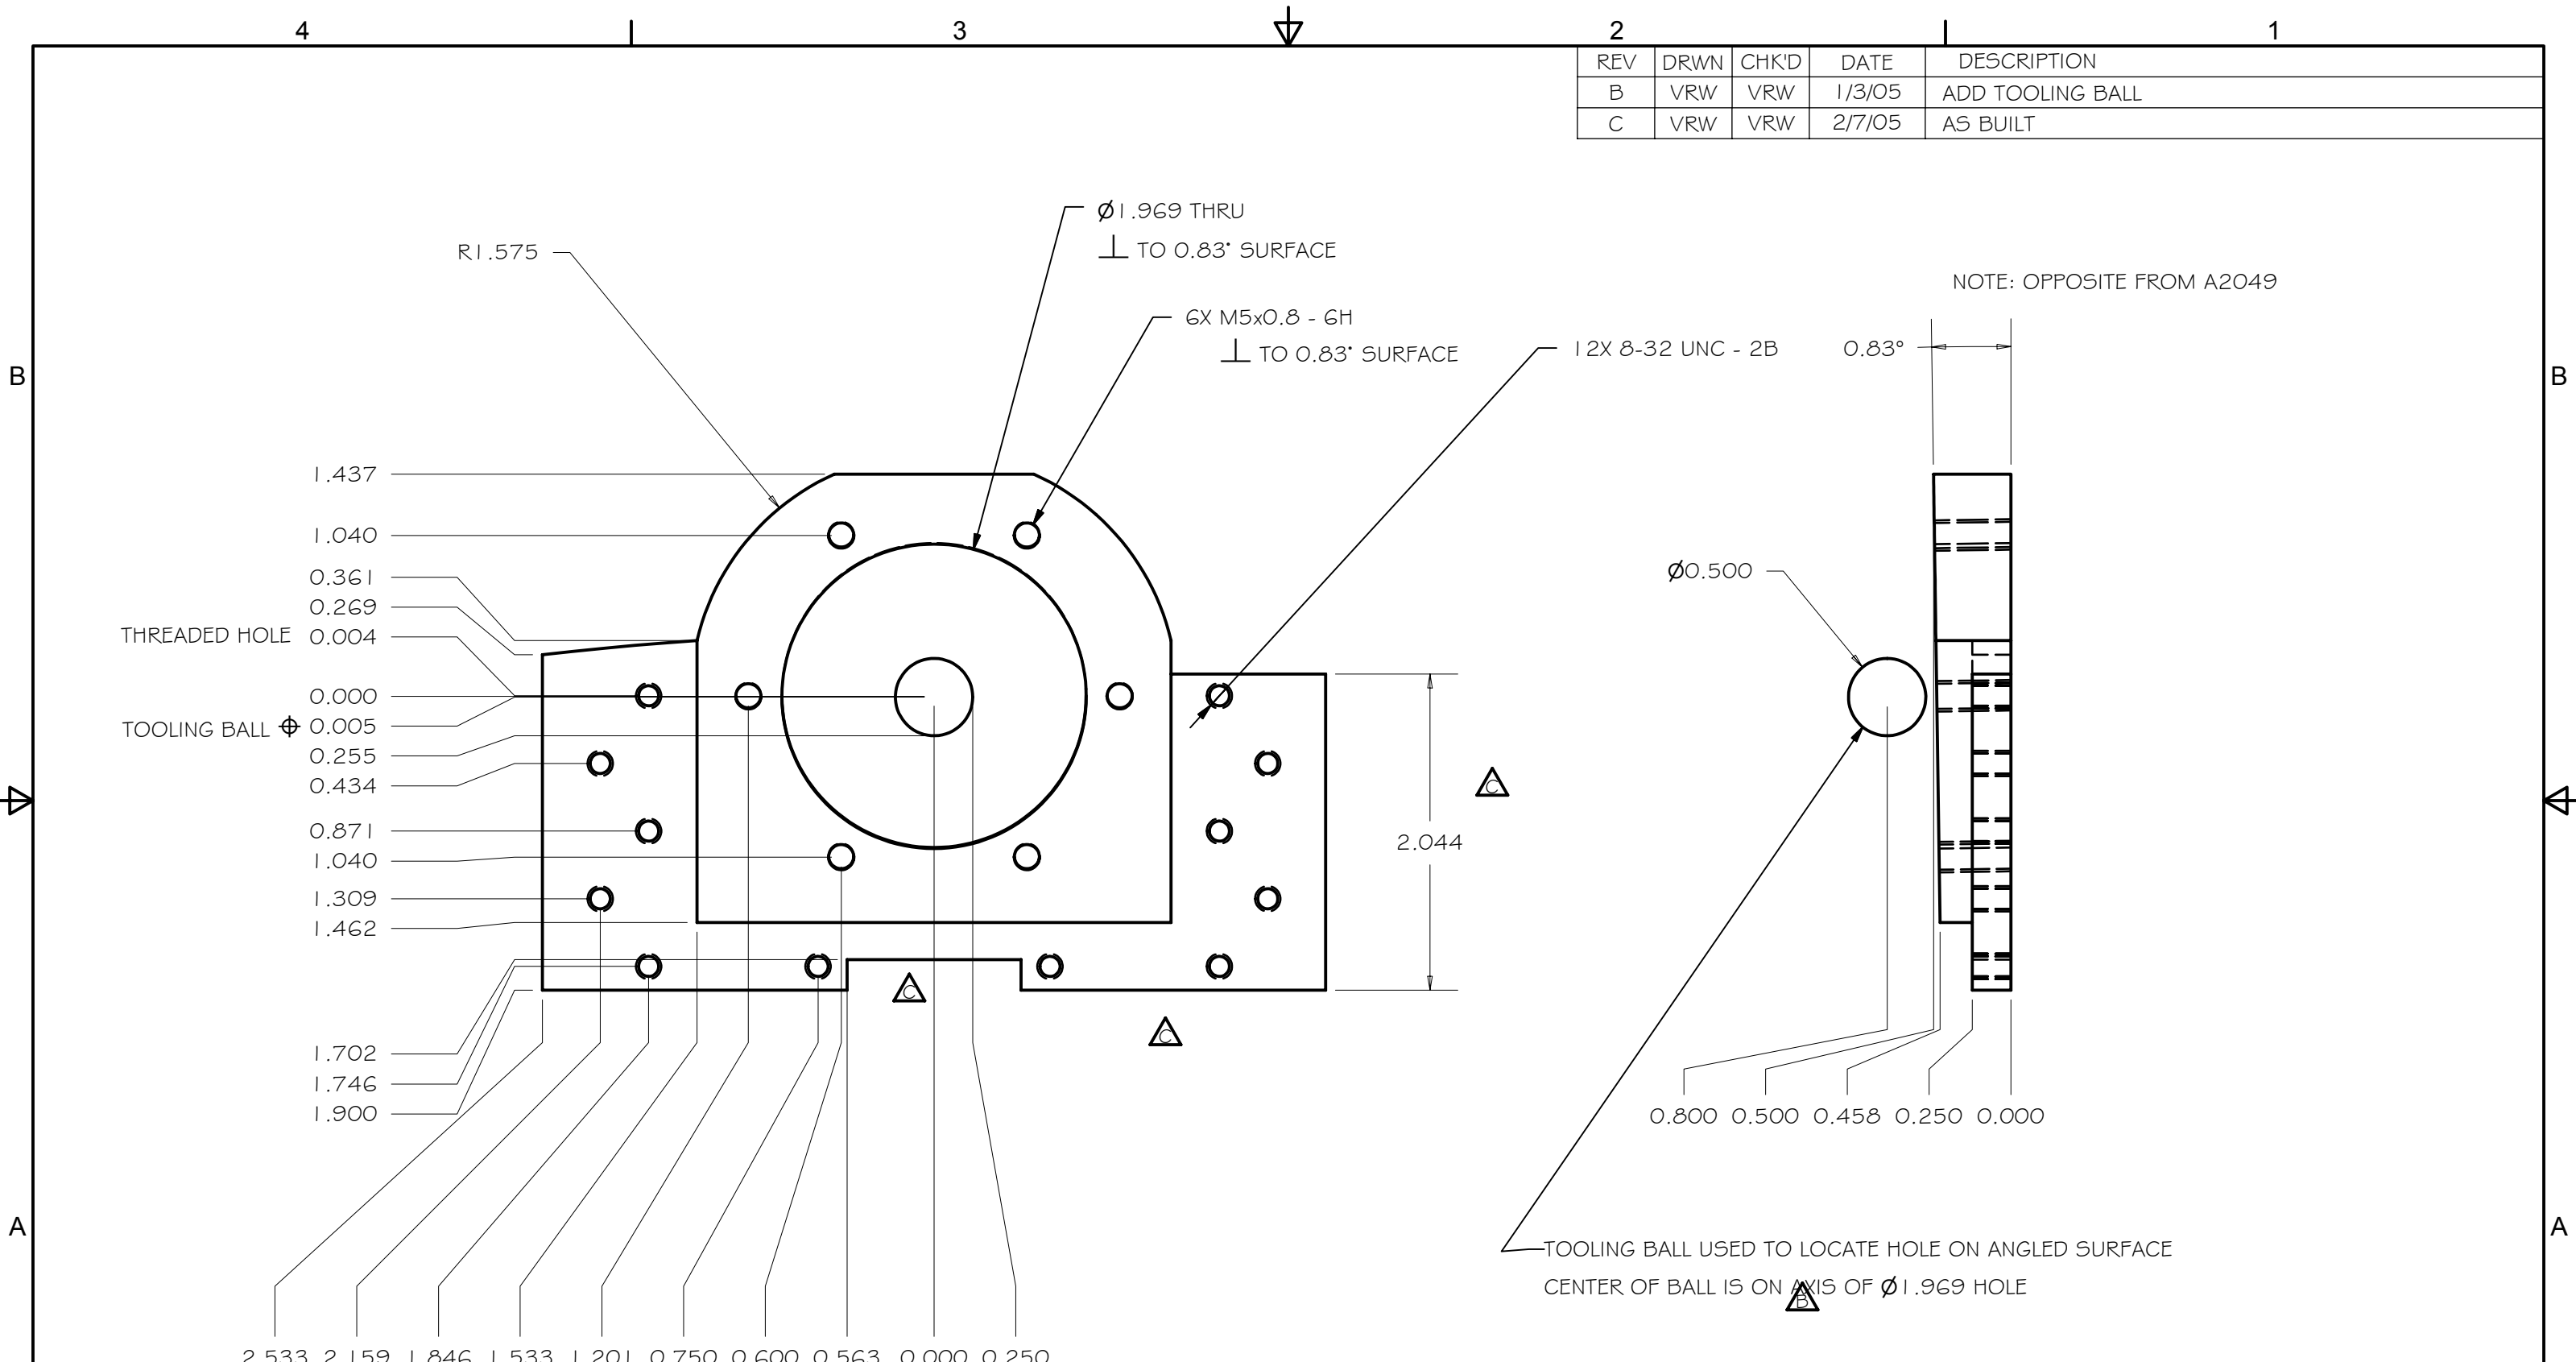

TOLERANCES UNLESS OTHERWISE NOTED:  
 FRACTIONAL: 0"-6": ±1/64" 6"-24": ±1/32"  
 24"+: ±1/16"  
 DECIMAL: X.X: ±0.1000" X.XX: ±0.0100"  
 X.XXX: ±0.0050" X.XXXX: ±0.0001"  
 ANGLES: ±0.5° FINISH: 125 MICRO INCHES  
 BREAK ALL SHARP EDGES & CORNERS 1/64" MAX

MATERIAL	FINISH
STEEL	



DRAWN	vernon	12/14/2004
CHECKED		
DESIGNED	vernon	
ENGINEER	vernon	
QTY: 1		

PROJECT CODE		DWG NO	REV
A2002		A2056	C
TITLE		FLANGE, DRIVE, AFT	
Cassegrain ADC			